



3131
TURTLE CREEK

SUITE 500

11,070 RSF

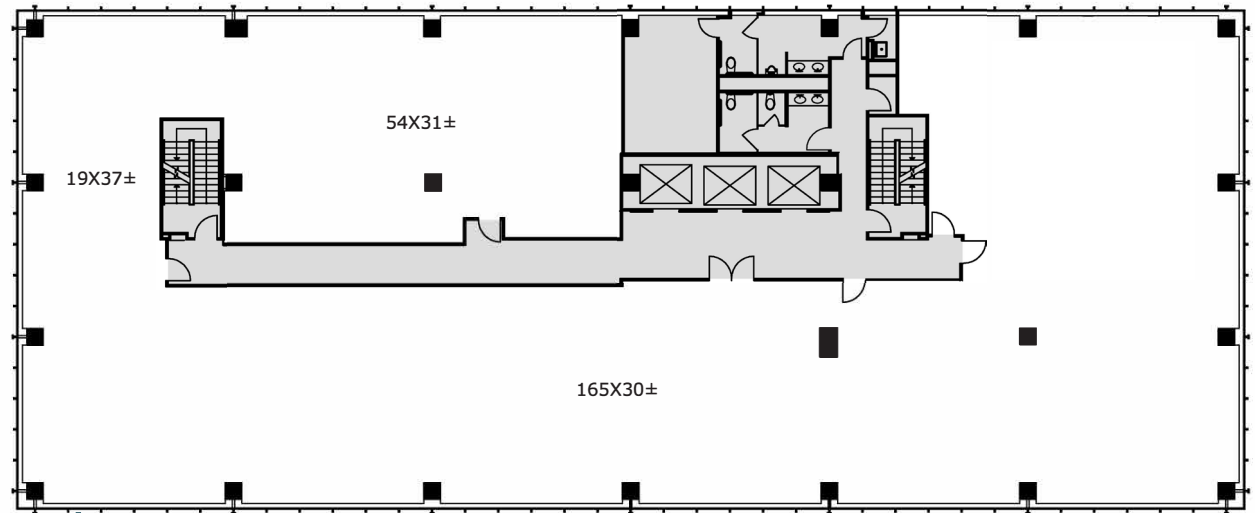

Whitebox

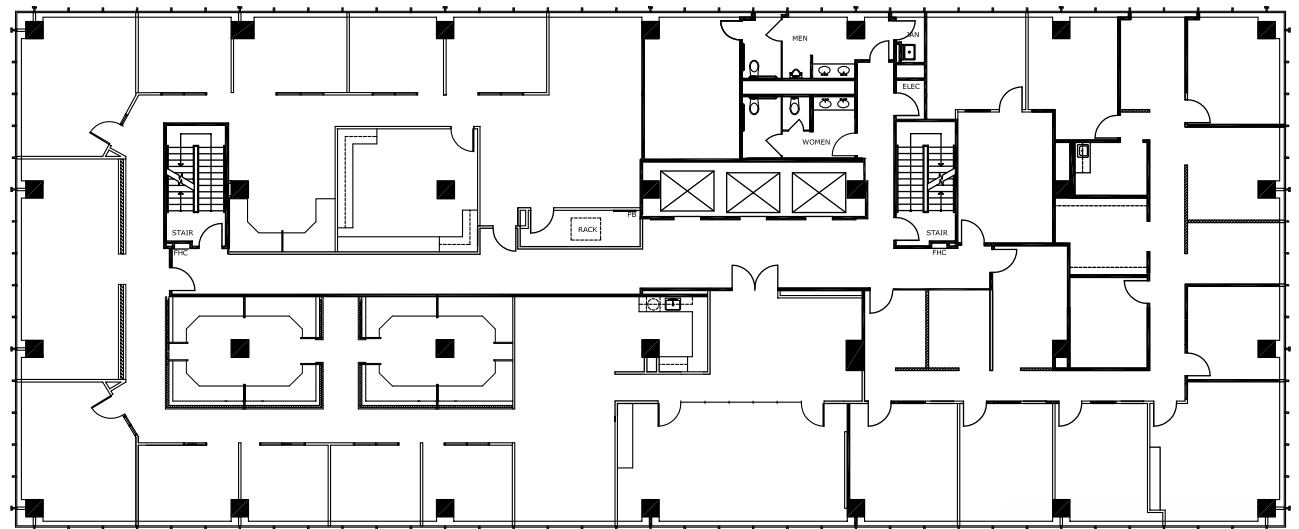

As-Built

For leasing information, contact:

+1 972 663 9600

2021 McKinney Avenue, Suite 900

Dallas, TX 75201

TREY SMITH

+1 972 663 9823

trey.smith@cushwake.com

LAUREN NAPPER

+1 972 663 9825

lauren.napper@cushwake.com



KEY PLAN

