

3131
TURTLE CREEK

For leasing information, contact:

+1 972 663 9600

2021 McKinney Avenue, Suite 900
Dallas, TX 75201

TREY SMITH

+1 972 663 9823
trey.smith@cushwake.com

LAUREN NAPPER


+1 972 663 9825
lauren.napper@cushwake.com



SUITE 600

2,329 RSF

As-Built

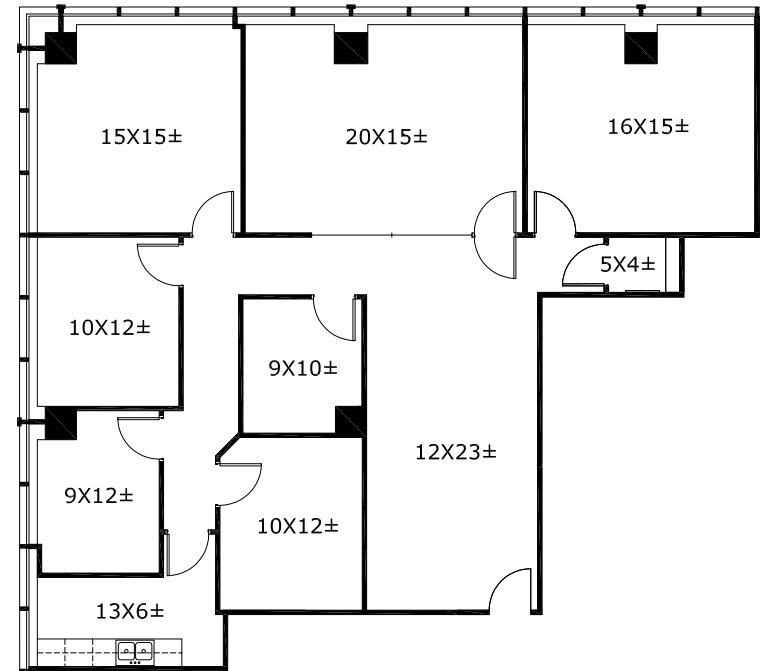

Hypothetical



Key Plan

